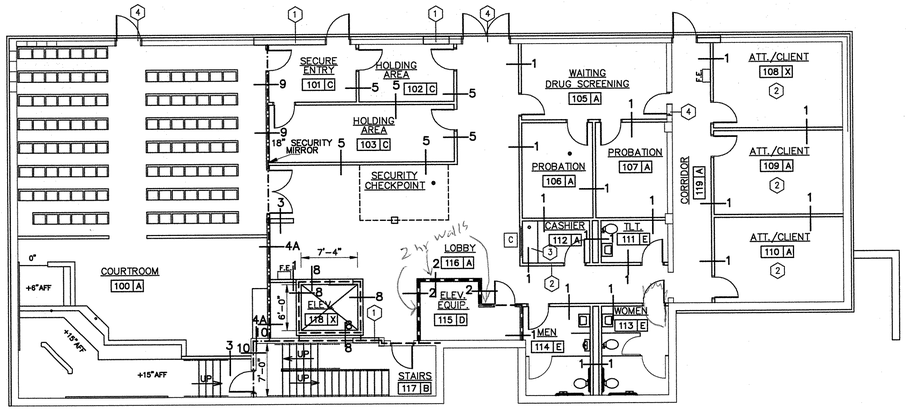

LOWER LEVEL LIFE SAFETY PLAN
SCALE: 1/8"=1'-0"

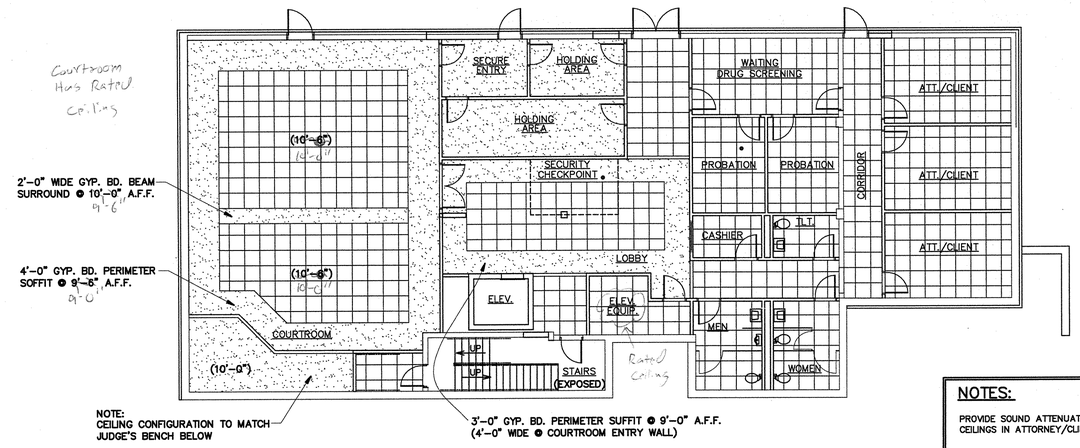

LOWER LEVEL REFLECTED CEILING PLAN
SCALE: 1/8"=1'-0"

NOTES:

PROVIDE SOUND ATTENUATION BLANKETS OVER CEILINGS IN ATTORNEY/CLIENT ROOMS

ALL CEILING HEIGHTS UNLESS NOTED OTHERWISE TO FIT AS TIGHT AS POSSIBLE TO UNDERSIDE OF DUCTWORK ON THIS LEVEL

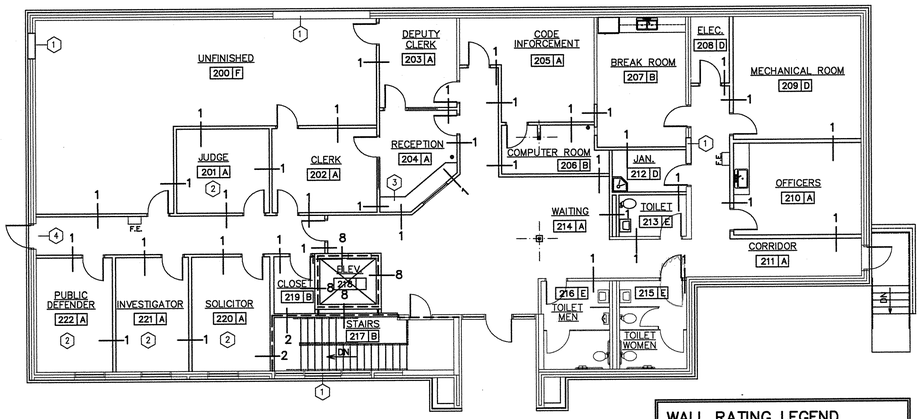

NOTE:
FOR WALL TYPES AND RATED WALLS, SEE DRAWING A104.

UPPER LEVEL LIFE SAFETY PLAN
SCALE: 1/8"=1'-0"

WALL RATING LEGEND

- 1 HOUR RATED WALLS
- 2 HOUR RATED WALLS

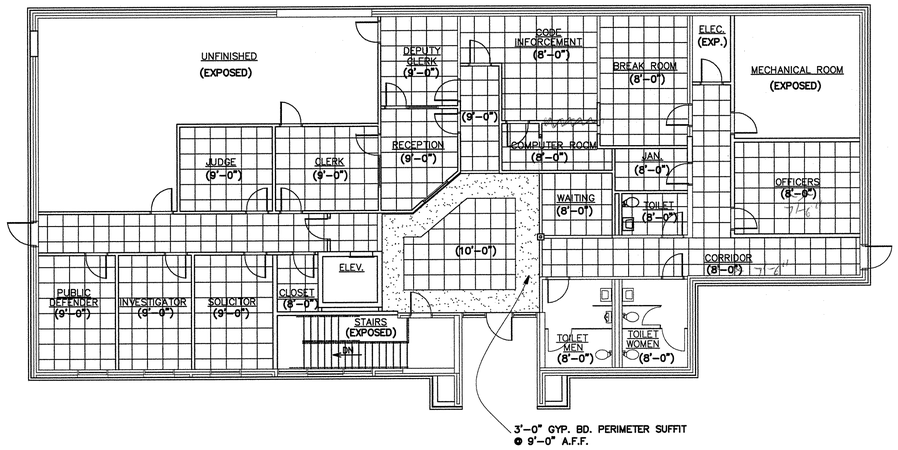

UPPER LEVEL REFLECTED CEILING PLAN
SCALE: 1/8"=1'-0"

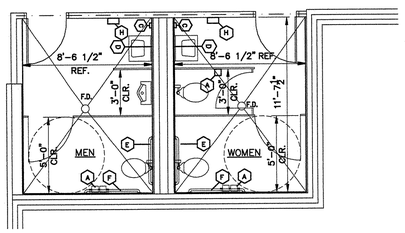

TOILETS AT LOWER & UPPER LEVEL
SCALE: 1/4"=1'-0"

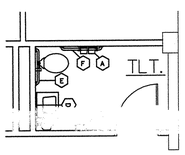

SINGLE TOILET AT LOWER & UPPER LEVEL
SCALE: 1/4"=1'-0"

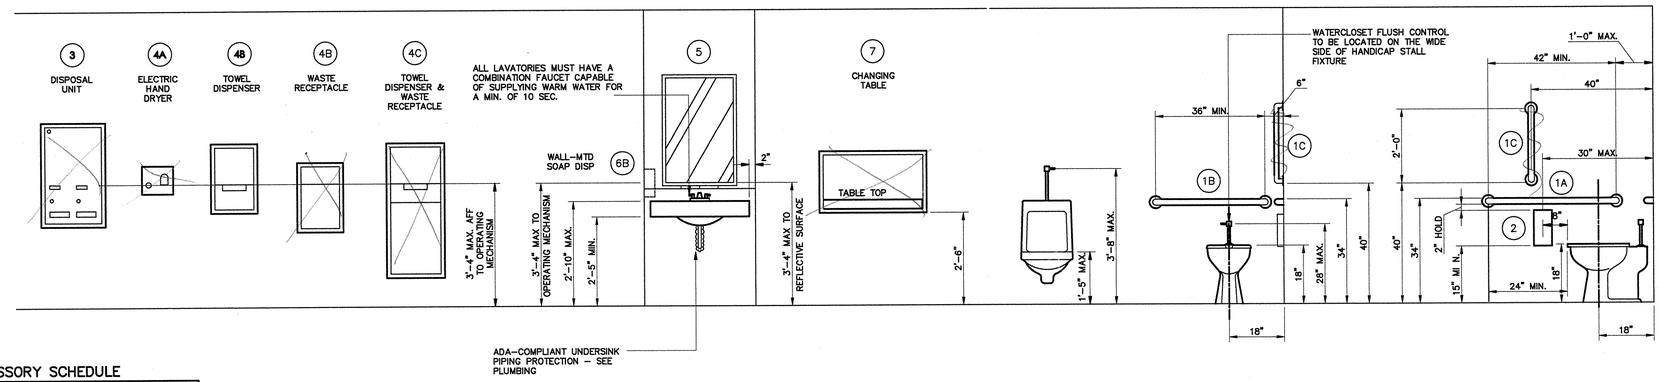

ELEVATIONS – TYPICAL ADA BATHROOM ACCESSORIES
NTS

TOILET ACCESSORY SCHEDULE

ITEM NO.	DESCRIPTION	CONTRACTOR SUP	CONTRACTOR INST	CONTRACTOR CON.	OTHERS SUP	OTHERS INST	OTHERS CON.	MANUF.	MODEL NUMBER
A	TOILET PAPER DISPENSER	●	●	●				BOBRICK	B-2888
B	TOWEL DIS./WASTE RECEP.	●	●	●				BOBRICK	B-3944
C	SOAP DISPENSER	●	●	●				BOBRICK	B-2111
D	PLATE MIRROR	●	●	●				BOBRICK	B-165 (1620)
E	HANDICAP GRAB BAR	●	●	●				BOBRICK	B-6806/36"
F	HANDICAP GRAB BAR	●	●	●				BOBRICK	B-6806/42"
G	MOP AND BROOM HOLDER	●	●	●				BOBRICK	B-239x44
H	TOWEL DISPENSER	●	●	●				BOBRICK	B-262

EQUIPMENT SCHEDULE NOTES:

1. REFER TO ACCESSORY ELEVATIONS FOR MOUNTING HEIGHTS
2. PROVIDE BLOCKING BEHIND ALL WALL MOUNTED EQUIPMENT AT HEIGHTS REQUIRED TO ANCHOR TO WALL. WOOD BLOCKING TO BE FIRE RETARDANT TREATED IN RATED PARTITIONS
3. PROVIDE (1) MOP & BROOM HOLDER IN JANITOR'S CLOSET

STATE OF GEORGIA
REGISTERED ARCHITECT

CONSTRUCTION MANAGERS
JTV General Contractors
1420 DEERTWOOD COURT
ROSWELL, GEORGIA 30075
TEL. 770-518-7080 FAX 770-518-0720

PROJECT NO:
•
CAD FILE:
•
DATE:
• 11-19-2009

REVISION	DATE
1	12-16-2009
2	12-31-2009
	02-05-2010
	03-04-2010
3	07-06-2010
	08-06-2010

NEW CONSTRUCTION FOR:
CITY OF STOCKBRIDGE MUNICIPAL COURT BUILDING
STOCKBRIDGE, GEORGIA

AS-BUILT DRAWINGS

PROJECT TITLE

ENGINEERS, INC.
ATLANTA, GEORGIA 30328
TEL. 404-256-1221 FAX 404-256-2043

SHEET TITLE
LIFE SAFETY PLANS
REFLECTED CEILING PLANS

DRAWING NUMBER
A102
OF